


**PARTIALLY SCANNED
OVERSIZE ITEM(S)**


To use oversize document #2279240
contact the Region IX Superfund Records Center

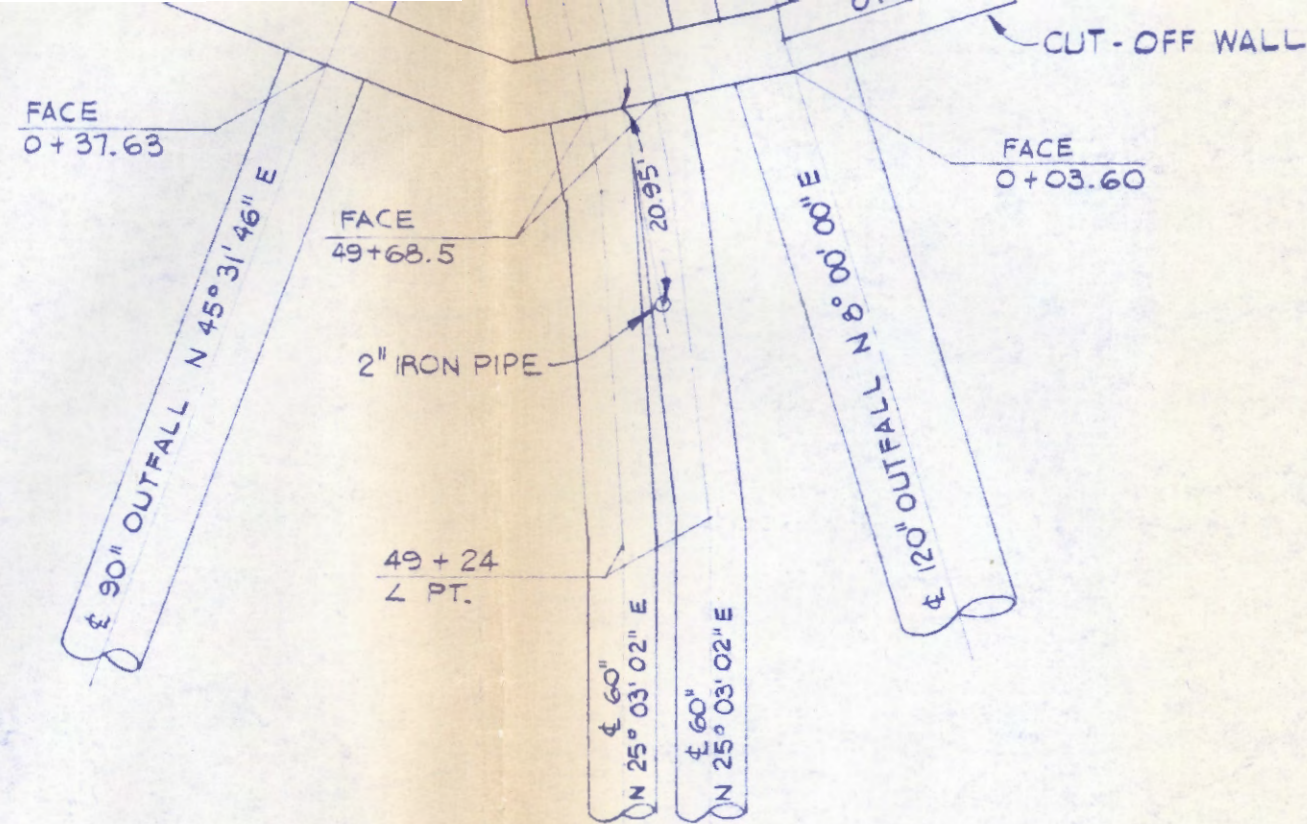

MANIFOLD STRUCTURE & CUT-OFF WALL

SCALE: 1" = 20'

NOTE: ELEVATIONS ARE IN FEET BELOW U.S.G.S. OR MEAN SEA LEVEL DATUM PLANE AND AS SUCH ARE APPROXIMATELY 2.7 FEET HIGHER THAN MEAN LOWER LOW WATER.

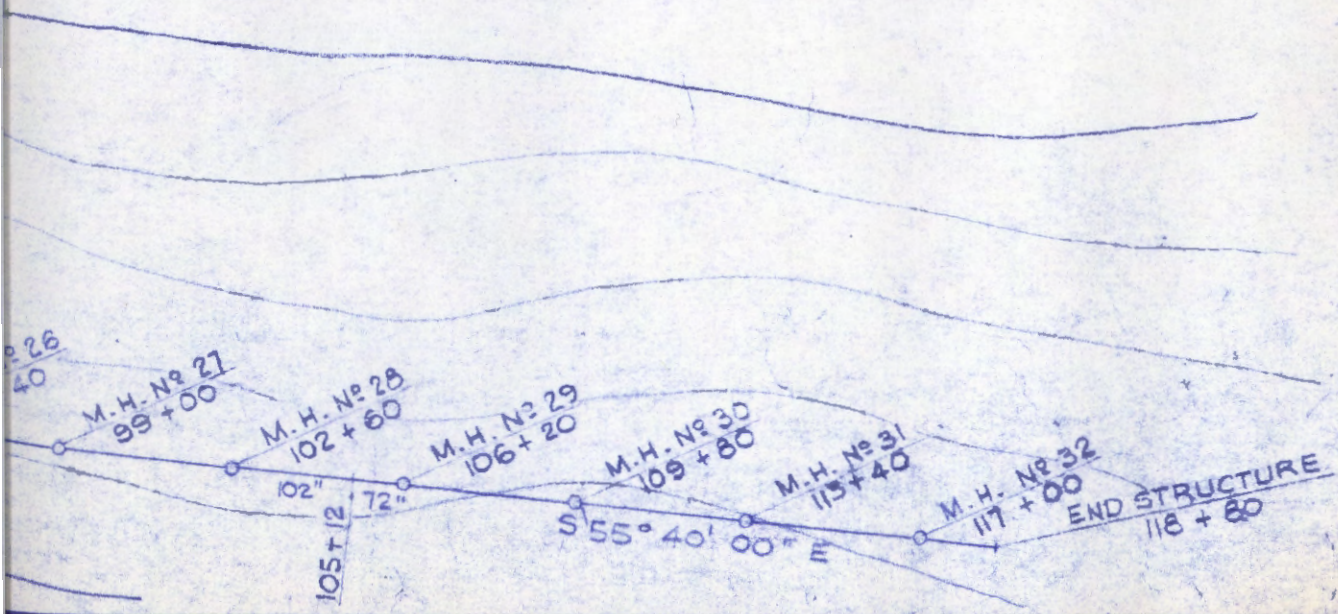

SCALE: 1" = 400' UNLESS NOTED

JO-p-112
SHEET No. 1
OF 1 SHEETS

DESIGNED		MAR. 1965
DRAWN	<i>pac</i>	MAR. 1965
TRACED		
CHECKED	<i>ba</i>	MAR. 1965

1	120" OUTFALL DIFFUSER AS BUILT & COORD. TABLE	<i>pac</i> <i>mn</i>	1-28-65
No	REVISION	INITIALS	DATE

COUNTY SANITATION DISTRICT NO
OF LOS ANGELES COUNTY, CALIF.
OFFICE OF CHIEF ENGINEER
JOINT OUTFALL "A" UNIT I-D

LAYOUT OF
OCEAN OUTFALLS

SFUND RECORDS CTR
2279240

SUBMITTED *J. Posthumus* OFFICE ENGINEER DATED MAR. 1965
RECOMMENDED _____ ASST. CHIEF ENGINEER DATED MAR. 1965
APPROVED _____ CHIEF ENGINEER DATED MAR. 1965